



DIAGRAM I
(1 FRAME - 1 DOOR)
TOP VIEW

SECTION VIEW

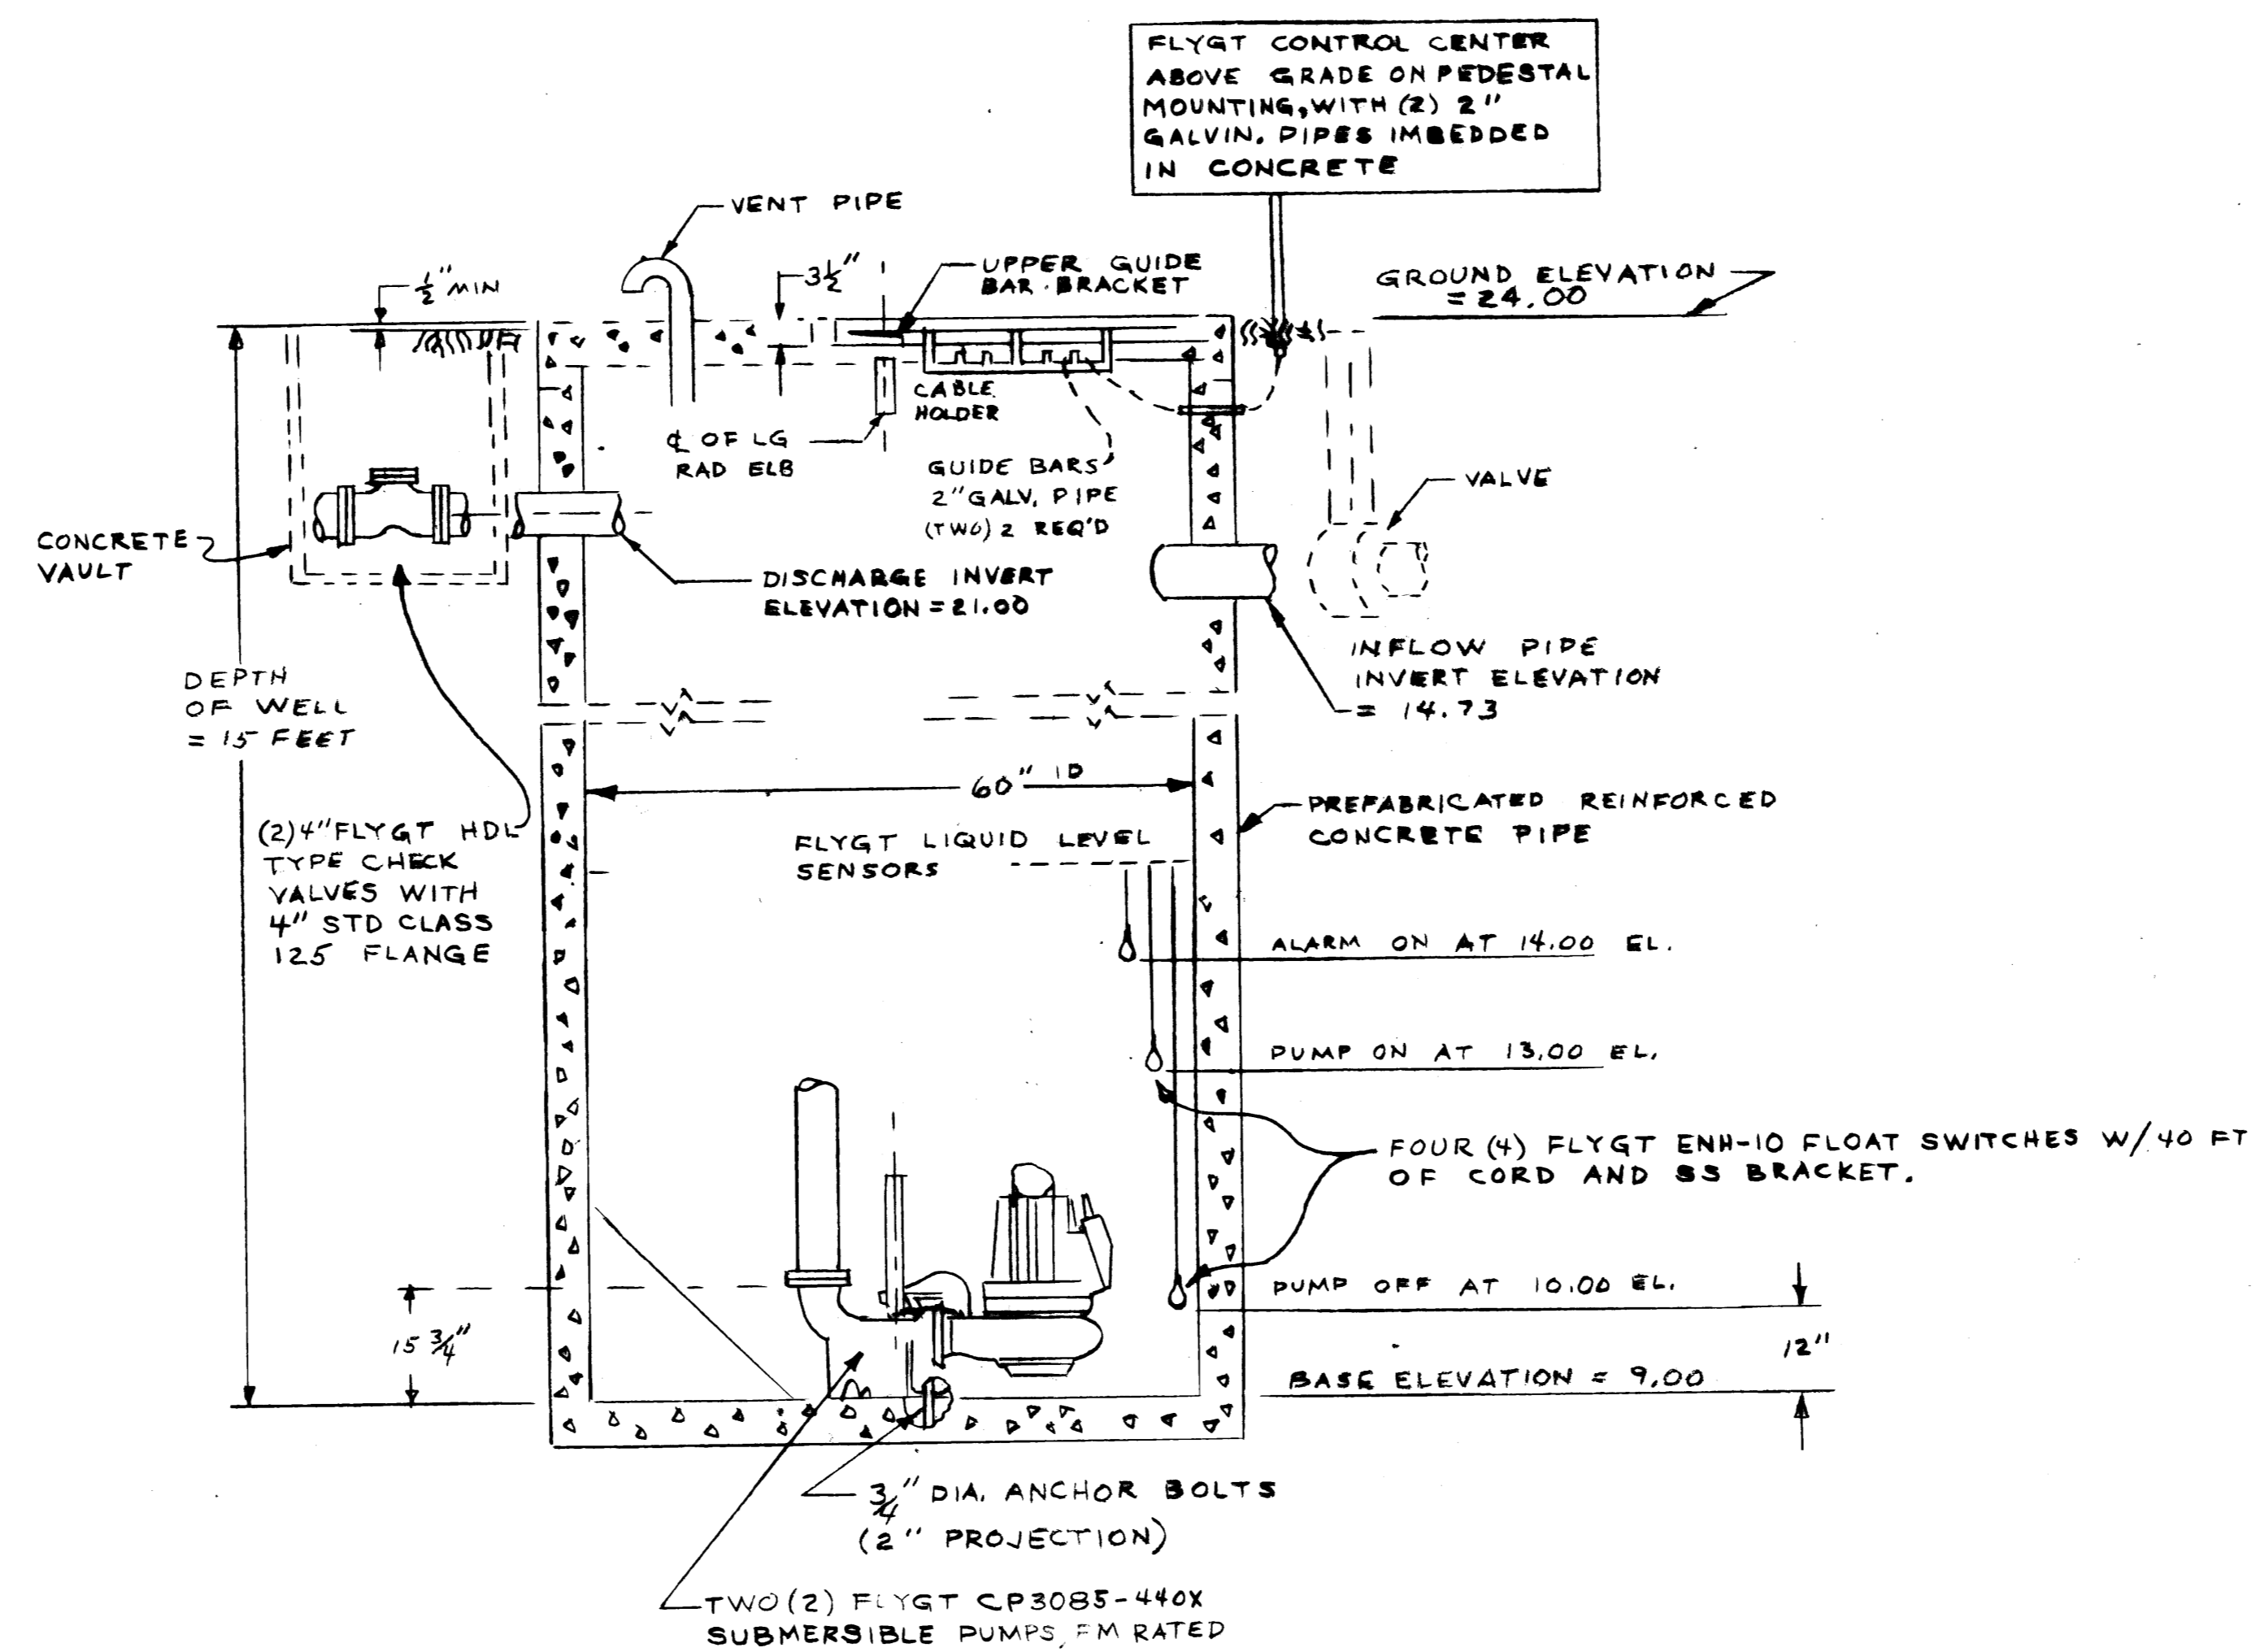

DESIGNED: AGG	HORZ. SCALE: NTS
DRAWN: AGG	VERT. SCALE: NTS
CHECKED: GS	DATUM
APPROVED: GS	DATE: 12-3-91
DATE	NO.
REVISION	BY

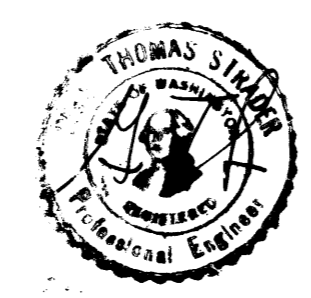

GENE T. STRADER ENG.
KELSO, WASH.

CP-3085
LIFT STATION, DUPLEX

LAKE PARK PLAT

SHEET NO.
3 OF 3
DRAWING NO.
1065